



Stanley H. Kellerhouse Municipal Building
One Van Wyck Street
Croton-on-Hudson, NY 10520.2501

Mayor
Leo A.W. Wiegman
Trustees
Ann H. Gallelli
Andrew C. Levitt
Brian Pugh
Maria F. Slippen
Manager
Abraham J. Zambrano
Treasurer
Sandra Bullock
Clerk
Pauline DiSanto
Engineer
Daniel E O'Connor, P.E.
Commissioner of Public
Works
Anthony R. Carr, PE, CFM

VIA EMAIL – 2 PAGES AND VILLAGE WEBSITE DATE: MARCH 18, 2015

TO: PROSPECTIVE PROPOSERS

**FROM: MR. ANTHONY R. CARR, PE, CFM
COMMISSIONER OF PUBLIC WORKS**

**RE: RFP FOR GEOTECHNICAL ENGINEERING FOR WATER DEPARTMENT REPLACEMENT
OF CULVERT STRUCTURES 1 AND 2 - ADDENDUM NO. 1 - RFP GENERAL REVISIONS**

The contents of this Addendum alter and amend the original RFP requirements and take precedence over the related items therein. This Addendum forms a part of the Contract Documents. Proposers must acknowledge receipt of all Addenda when submitting their proposals. Failure to acknowledge receipt may render a Proposer non-responsive and ineligible for award. All Addenda for this RFP can be downloaded from the Village's website at [http://www.crotononhudson-nv.gov/Public_Documents/CrotonHudsonNY_Quicklinks/Bids, RFP's, RFQ's and Addenda](http://www.crotononhudson-nv.gov/Public_Documents/CrotonHudsonNY_Quicklinks/Bids,_RFP's,_RFQ's_and_Addenda). Vendors are responsible for ensuring that they receive all Addenda.

**PLEASE NOTE THE FOLLOWING: THE PROPOSAL DUE DATE HAS BEEN REVISED TO
FRIDAY, MARCH 20, 2015 AT 2:00 PM.**

ATTACHED ARE REVISIONS AND CLARIFICATION TO THE RFP.

If you are planning to submit a proposal, please acknowledge receipt of Addendum No. 1 by completing the following and returning via fax or email.

Firm:

Address:

Representative:

Title:

E-mail:

Telephone:

Fax:

Date:

RFP GENERAL REVISIONS



1. The RFP due date has been changed from Friday, March 13, 2015 to **Friday, March 20, 2015**. The proposal due time remains the same.
2. On Page 8, Section II “Scope of Work”, "A. Phase 1- Subsurface Investigation and Laboratory Testing” replace “...*eight (8) proposed test borings with continuous split spoons samples collected at two (2) foot intervals to a depth of approximately ten (10) feet below existing grade.*” with the following:

“...four (4) proposed test borings with continuous split spoons samples collected at two (2) foot intervals, with two (2) borings extending approximately twenty-five (25) linear feet (LF) and two (2) borings extending approximately thirty-five (35) LF below grade.”
3. Proposers shall note that the four (4) proposed testing boring locations shall be generally located as illustrated on RFP Supplemental Drawings BLP-1 and BLP-2 “Test Boring Location Plan”, last revised March 16, 2015. Prior to the start of work, final test boring locations will be field verified with the Commissioner of Public Works and other Village Staff.

END OF ADDENDUM NO. 1

LEGEND

SB-1 LOCATION OF PROPOSED TEST BORING

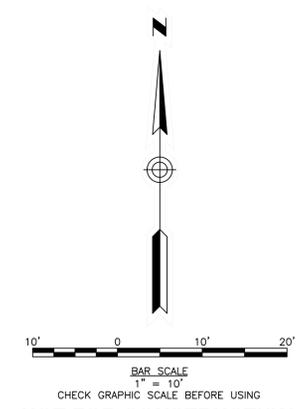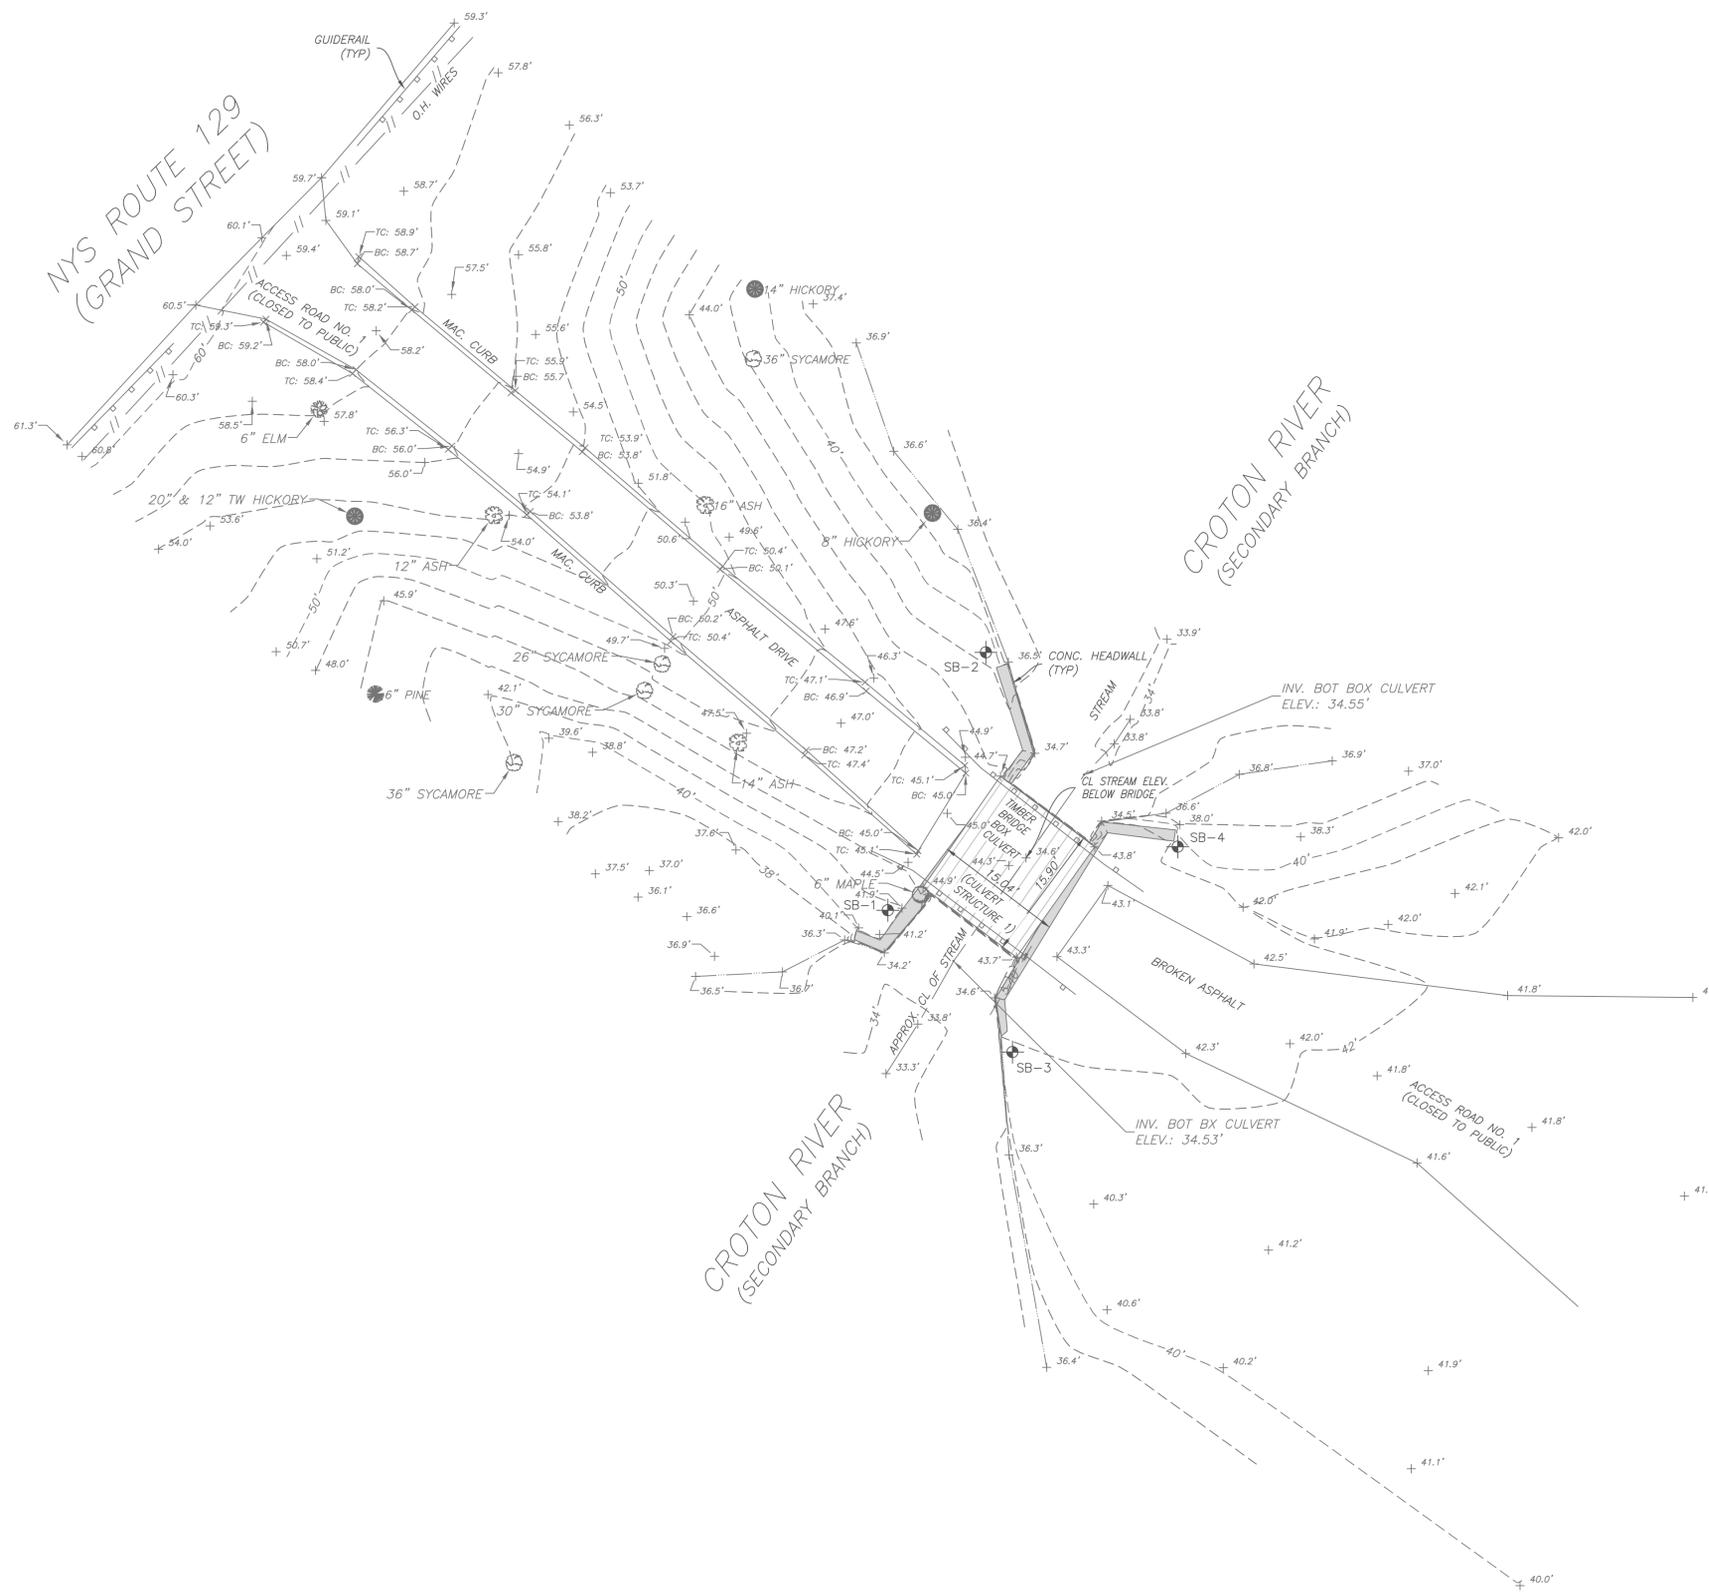

NOT FOR CONSTRUCTION

ANY ALTERATION OF PLANS, SPECIFICATIONS, PLATS AND REPORTS BEARING THE SEAL OF A LICENSED PROFESSIONAL ENGINEER OR LICENSED LAND SURVEYOR IS A VIOLATION OF SECTION 7209 OF THE NEW YORK STATE EDUCATION LAW, EXCEPT AS PROVIDED FOR BY SECTION 7209, SUBSECTION 2.

IN CHARGE OF ARC, PE
 CHECKED BY ARC, PE
 MADE BY ARC, PE



VILLAGE OF CROTON-ON-HUDSON
 STANLEY H. KELLERHOUSE MUNICIPAL BUILDING
 1 VAN WYCK STREET (2nd FLOOR)
 WESTCHESTER COUNTY
 VILLAGE OF CROTON-ON-HUDSON, NY 10520
 PHONE: (914) 271-3775
 FAX: (914) 271-2856




REVISION BLOCK			
REVISION NUMBER	DATE	APP'D BY	REVISION
1.	03/16/2015	ARC, PE	REVISED TEST BORING LOCATIONS AND DEPTHS
0.	03/06/2015	ARC, PE	ISSUED FOR SUBSURFACE INVESTIGATION RFP

RECORD DRAWING CERTIFICATION			
WATER DEPARTMENT FOREMAN		PUBLIC WORKS GENERAL FOREMAN	
NAME	MR. JOHN SPATTA	NAME	MR. MARTIN GARIEPY
SIGNATURE	_____	SIGNATURE	_____
TITLE	_____	TITLE	_____
VILLAGE ENGINEER		COMMISSIONER OF PUBLIC WORKS	
NAME	MR. DANIEL E. O'CONNOR, PE	NAME	MR. ANTHONY R. CARR, PE, CFM
SIGNATURE	_____	SIGNATURE	_____
TITLE	_____	TITLE	_____


VILLAGE OF CROTON-ON-HUDSON DEPARTMENT OF PUBLIC WORKS OFFICE OF MR. ANTHONY R. CARR, PE, CFM COMMISSIONER OF PUBLIC WORKS		VOCOH CONTRACT NUMBER 2015-XX	SHEET NUMBER BLP-1
VILLAGE WATER DEPARTMENT REPLACEMENT OF CULVERT STRUCTURES 1 & 2 340 GRAND STREET (SBL: 68.14-3-3) VILLAGE OF CROTON-ON-HUDSON, NY 10520 TEST BORING LOCATION PLAN (CULVERT STRUCTURE 1)		SHEET NO. 2 OF 3	SCALE: 1"=10'
		DATE: MARCH 6, 2015	REV. NO.: 1

LEGEND

SB-1 LOCATION OF PROPOSED TEST BORING

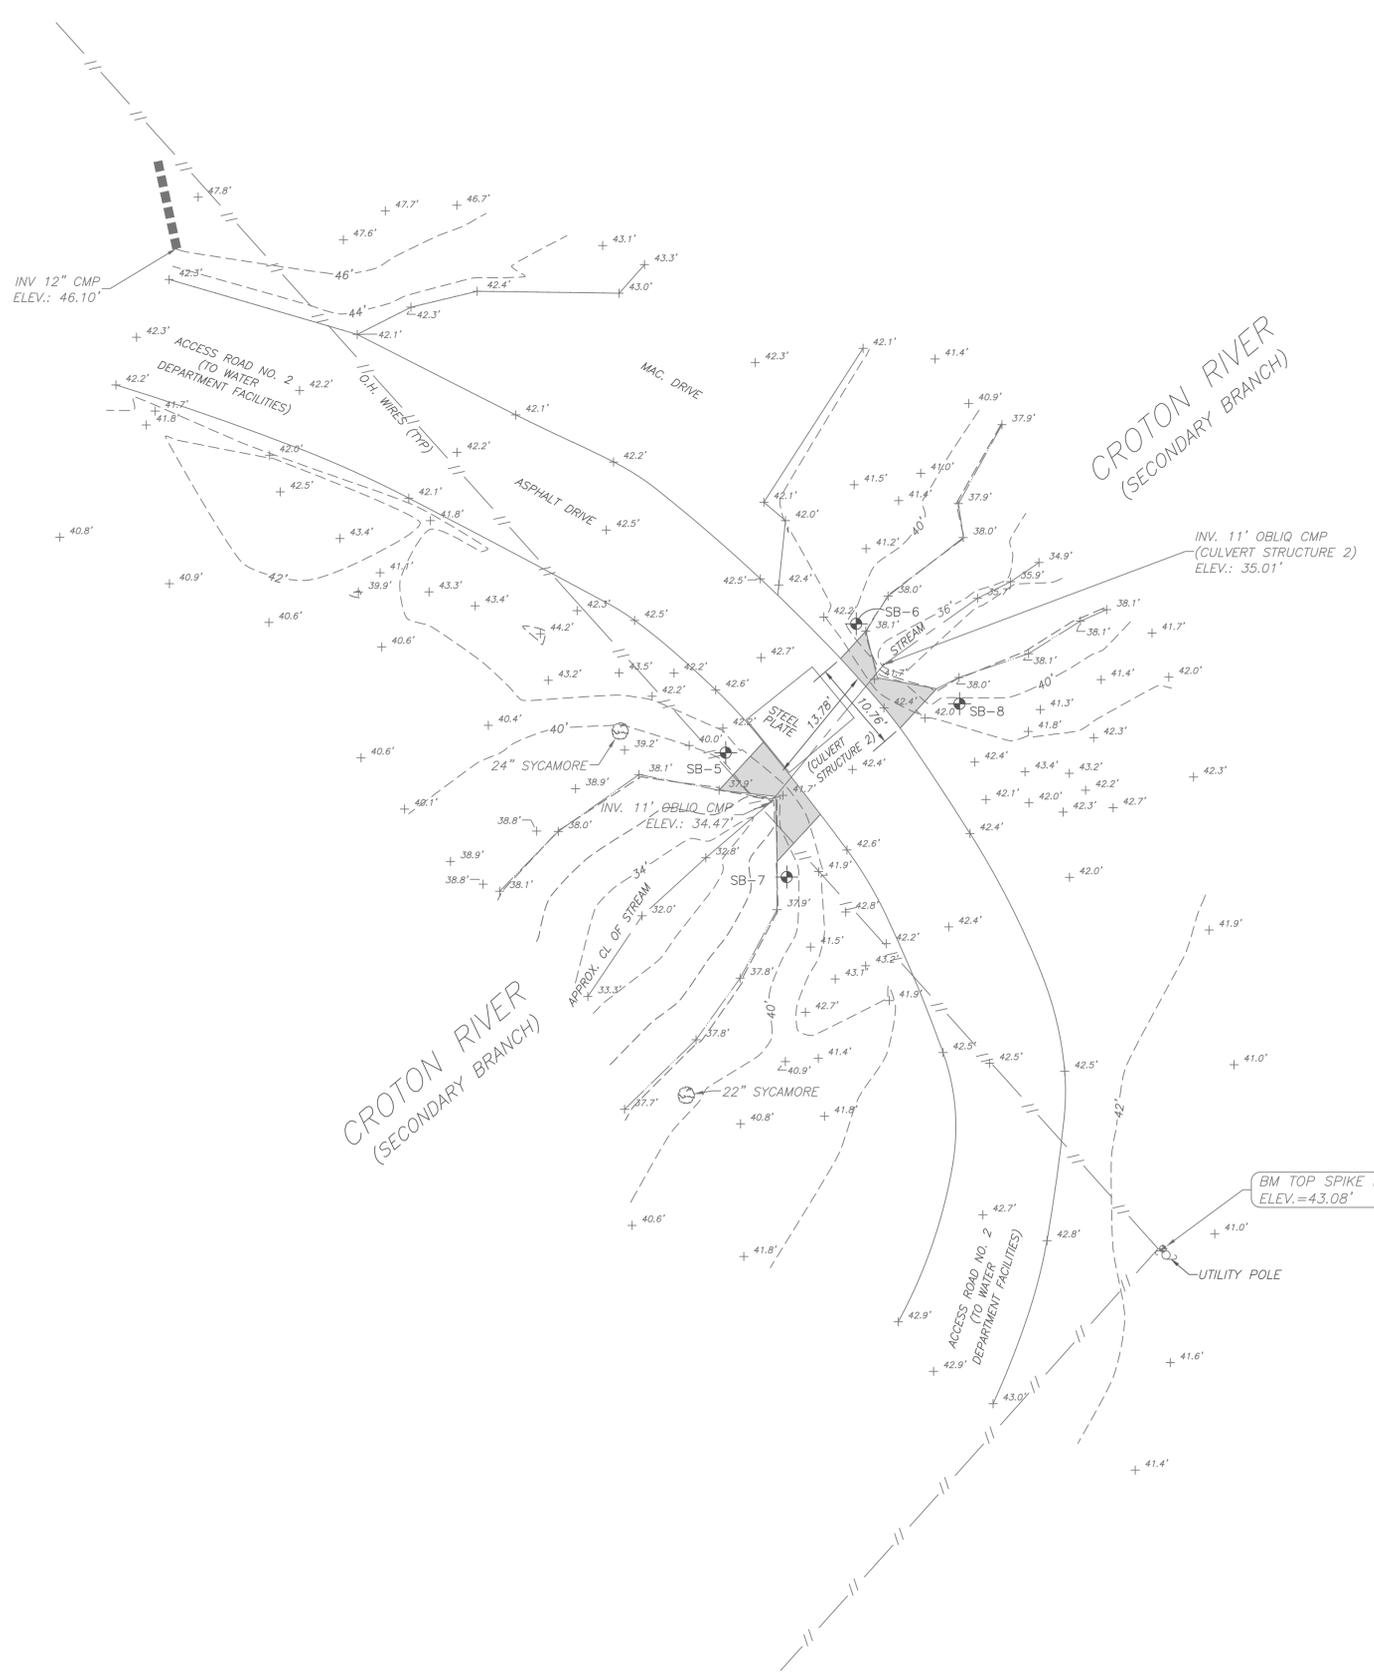

BM TOP SPIKE IN UTILITY POLE
ELEV.=43.08'

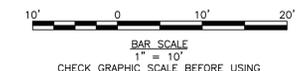

NOT FOR CONSTRUCTION

ANY ALTERATION OF PLANS, SPECIFICATIONS, PLATS AND REPORTS BEARING THE SEAL OF A LICENSED PROFESSIONAL ENGINEER OR LICENSED LAND SURVEYOR IS A VIOLATION OF SECTION 7209 OF THE NEW YORK STATE EDUCATION LAW, EXCEPT AS PROVIDED FOR BY SECTION 7209, SUBSECTION 2.

IN CHARGE OF ARC, PE
 CHECKED BY ARC, PE
 MADE BY ARC, PE

VILLAGE OF CROTON-ON-HUDSON
 STANLEY H. KELLERHOUSE MUNICIPAL BUILDING
 1 VAN WYCK STREET (2nd FLOOR)
 WESTCHESTER COUNTY
 VILLAGE OF CROTON-ON-HUDSON, NY 10520
 PHONE: (914) 271-3775
 FAX: (914) 271-2856

REVISION BLOCK			
REVISION NUMBER	DATE	APP'D BY	REVISION
1.	03/16/2015	ARC, PE	REVISED TEST BORING LOCATIONS AND DEPTHS
0.	03/06/2015	ARC, PE	ISSUED FOR SUBSURFACE INVESTIGATION RFP

RECORD DRAWING CERTIFICATION

<input type="checkbox"/> AS BUILT - CHANGES AS NOTED <input type="checkbox"/> AS BUILT - NO CHANGES	
<p style="text-align: center;">WATER DEPARTMENT FOREMAN</p> NAME <u>MR. JOHN SPATTA</u> SIGNATURE _____ DATE _____ TITLE _____ <p style="text-align: center;">VILLAGE ENGINEER</p> NAME <u>MR. DANIEL E. O'CONNOR, PE</u> SIGNATURE _____ DATE _____ TITLE _____	<p style="text-align: center;">PUBLIC WORKS GENERAL FOREMAN</p> NAME <u>MR. MARTIN GARIEPY</u> SIGNATURE _____ DATE _____ TITLE _____ <p style="text-align: center;">COMMISSIONER OF PUBLIC WORKS</p> NAME <u>MR. ANTHONY R. CARR, PE, CFM</u> SIGNATURE _____ DATE _____ TITLE _____

VILLAGE OF CROTON-ON-HUDSON DEPARTMENT OF PUBLIC WORKS OFFICE OF MR. ANTHONY R. CARR, PE, CFM COMMISSIONER OF PUBLIC WORKS		VOCH CONTRACT NUMBER 2015-XX	SHEET NUMBER BLP-2
VILLAGE WATER DEPARTMENT REPLACEMENT OF CULVERT STRUCTURES 1 & 2 340 GRAND STREET (SBL: 68.14-3-3) VILLAGE OF CROTON-ON-HUDSON, NY 10520 TEST BORING LOCATION PLAN (CULVERT STRUCTURE 2)		SHEET NO. 3 OF 3 SCALE: 1"=10' DATE: MARCH 6, 2015 DEPARTMENT OF PUBLIC WORKS FILE NO. -	
		REV. NO.: 0	